


BACK ELEVATION

H80 GRATING
TO SWING DOWN
& EXTEND OUT TO
STAND ON

(MUST BE
BONDED)

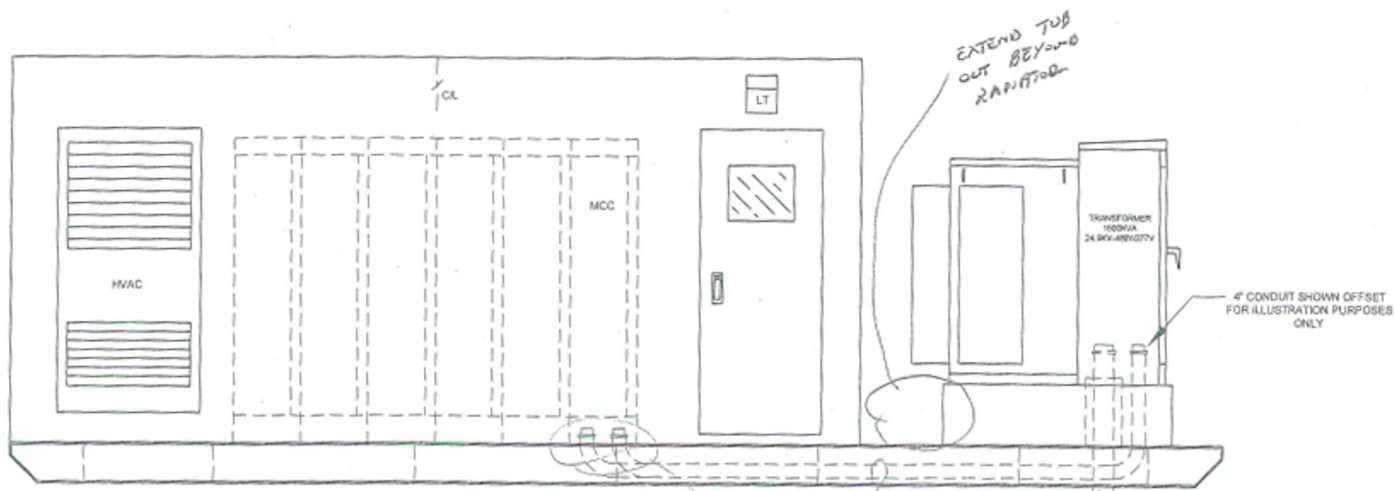

FRONT ELEVATION

REVISE FOR
ENTER, NOT CONDUIT

CLIENT REVIEW _____
DATE _____
AS BUILT: none

AEA ARIZONA ELECTRICAL APPARATUS	PROJECT: WATER SYSTEM BOOSTER PUMP E-HOUSE
	DWG TITLE: E-HOUSE ELEVATION VIEWS
	DWG NO. AEA-110112-10
	DATE: _____